


Ownership File No. 351  
 Name of Condominium The D'Evans Project, a Condominium **CONDOMINIUM PROJECT**  
 Declaration recorded on Dec. 22, 1987 **5667**  
 Pages 132 thru 164  
 Plans: Sheets 1 thru 1  
 Title 72 day of December 1987  
 Charles E. Crowder, Register of Deeds  
 By Henry L. Parnell Deputy

PLAT SHOWING  
**"D'EVANS PROJECT"**  
 PROPERTY OF BOB GODLEY ENTERPRISES  
 CHARLOTTE, MECKLENBURG COUNTY, N.C.  
 SCALE: 1" = 30' DEC. 10, 1987  
 HENRY L. PARNELL, REG. SURVEYOR L-681

PRESENTED FOR REGISTRATION  
 DEC 22 4 01 PM '87  
 CHARLES E. CROWDER REGISTER MECKLENBURG CO. N.C.


Second Amendment to Declaration filed April 21st in Book 5744, Page - 326 - Plan Sheet # 2  
 Third Page - 328

Second Amendment to Declaration filed 6-1-87 in Book 6055 page 994 thru 996. Plan Sheet # 3

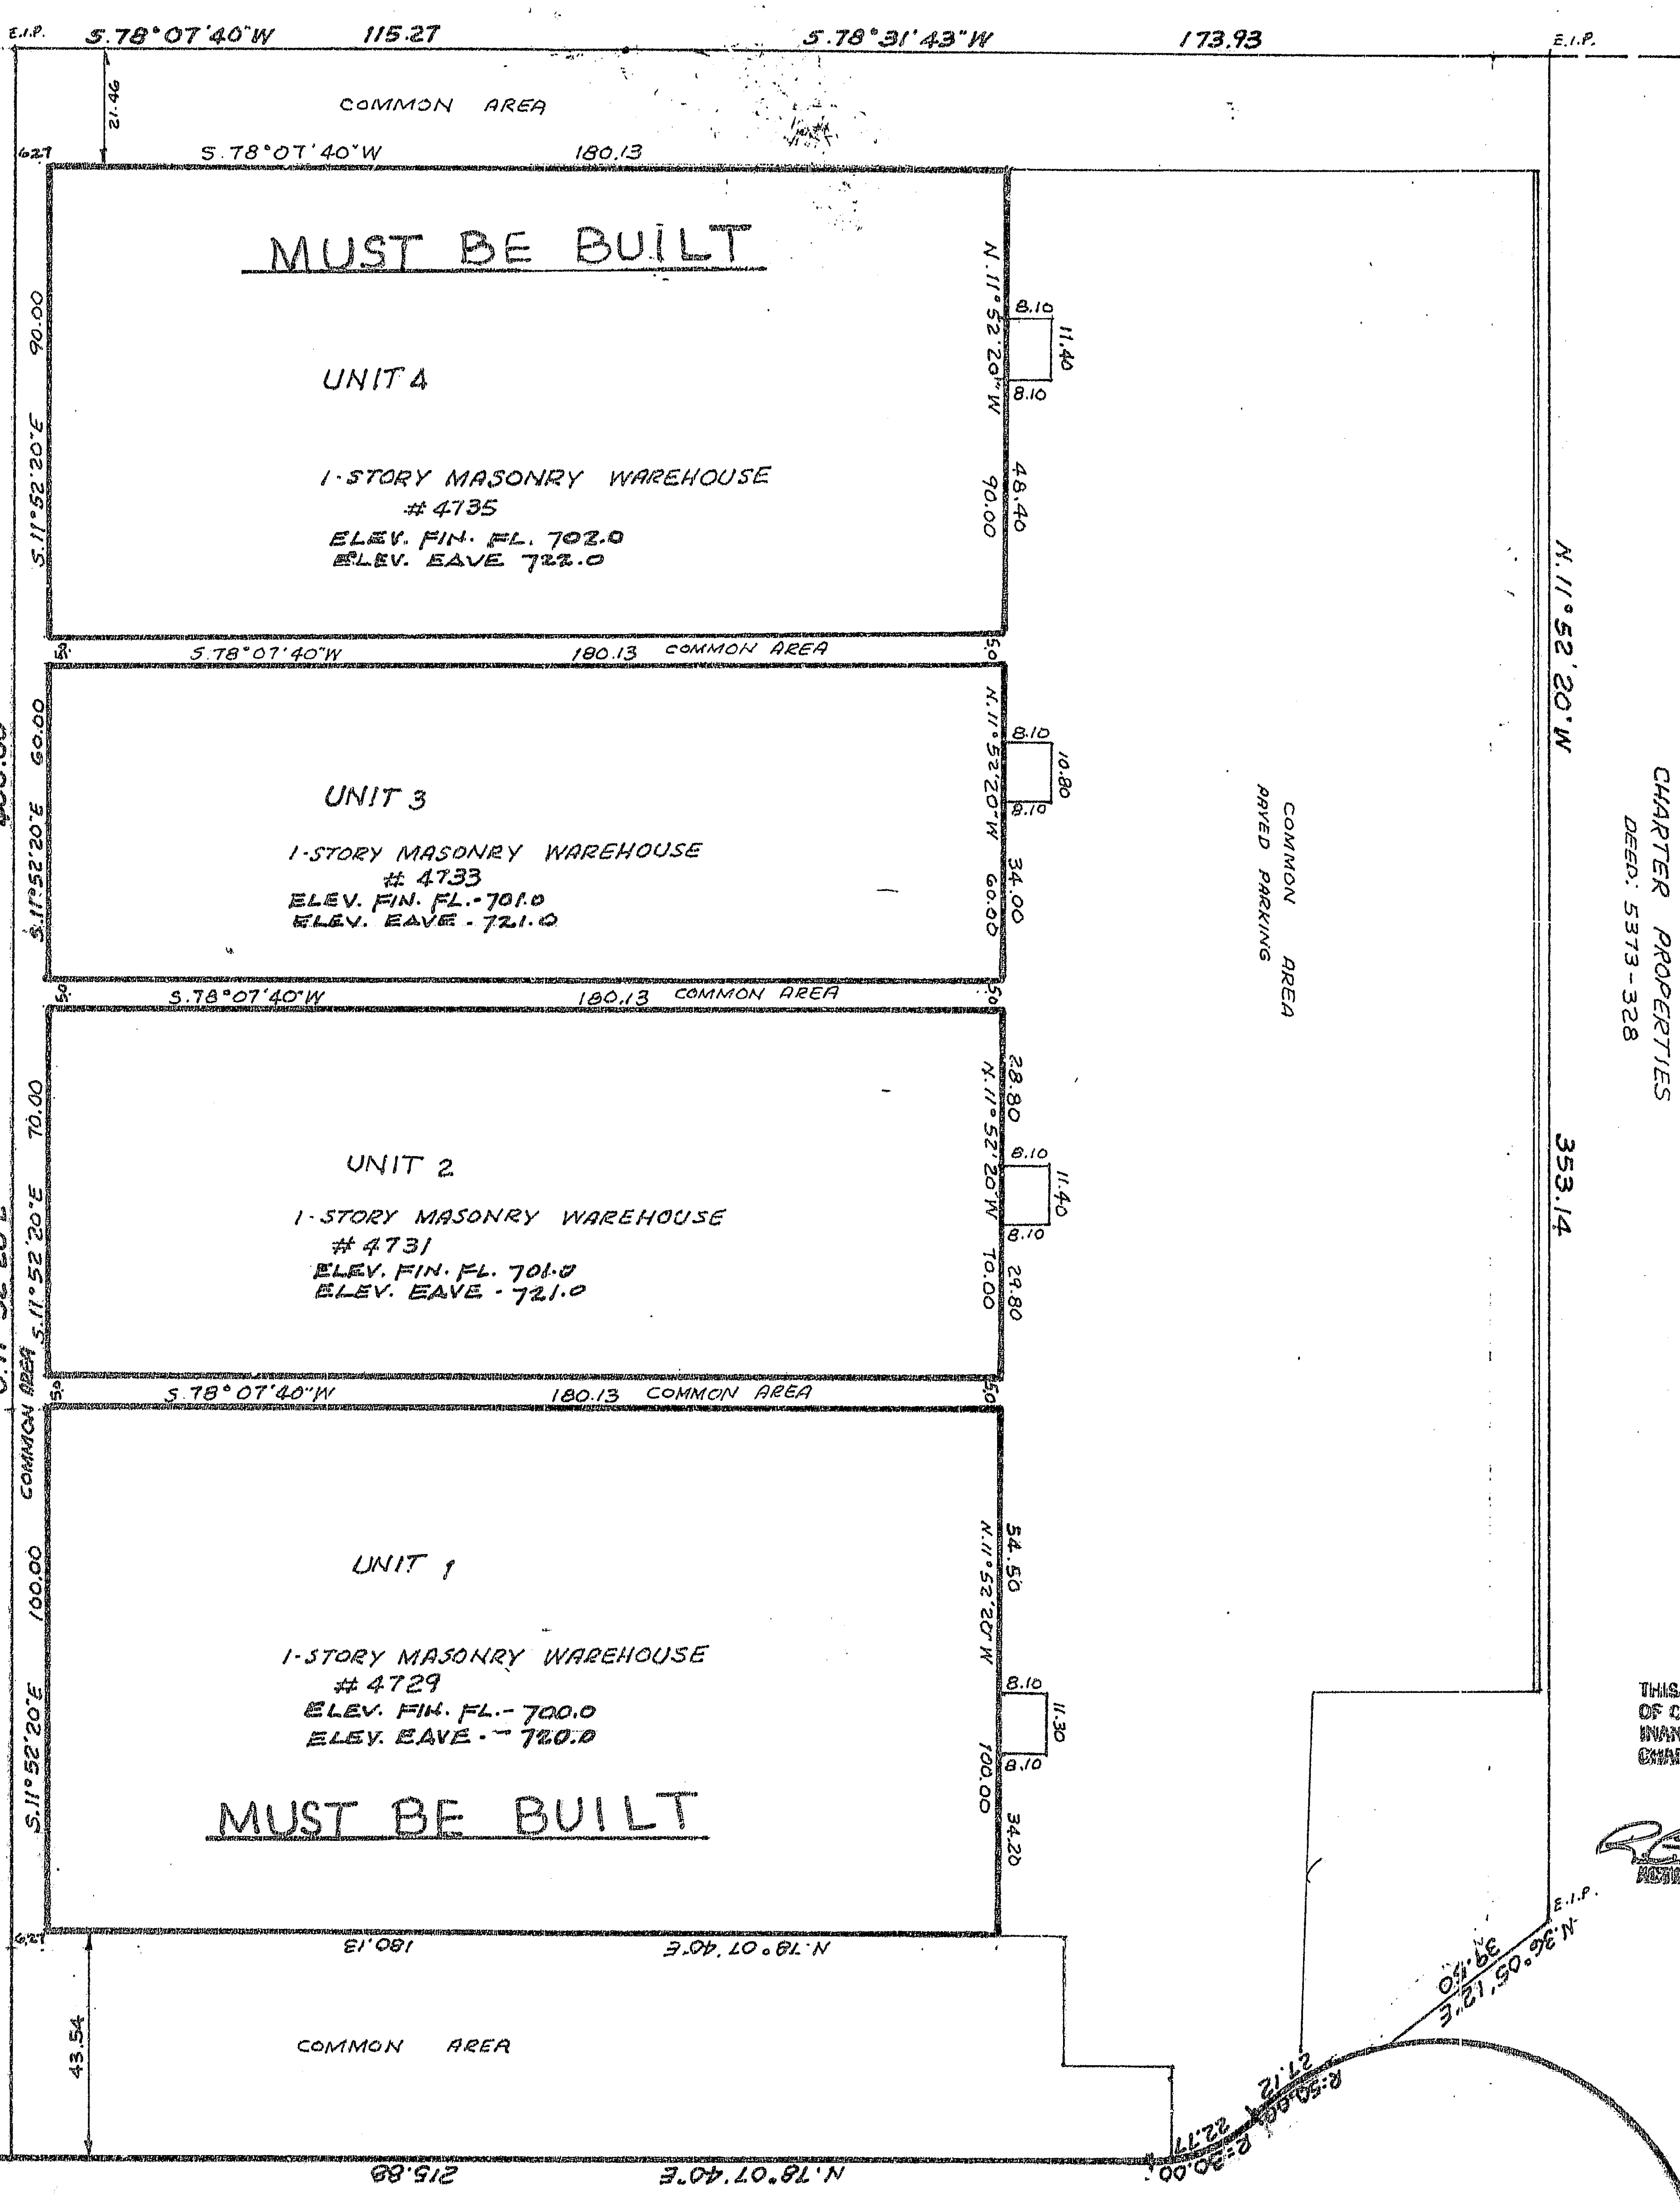

State of North Carolina  
 County of Mecklenburg  
 The undersigned surveyor, being duly sworn, deposes and says that the plat upon which this certificate appears was prepared in accordance with G.S. 47-30 as amended, is in all respects correct according to the best of his knowledge and belief, and was prepared from an actual survey made by him on the 10th day of DECEMBER, 1987, with a maximum linear error of closure of 1/10,000, and a maximum field error of angular closure of 7.5


Henry L. Parnell  
 Registered Surveyor

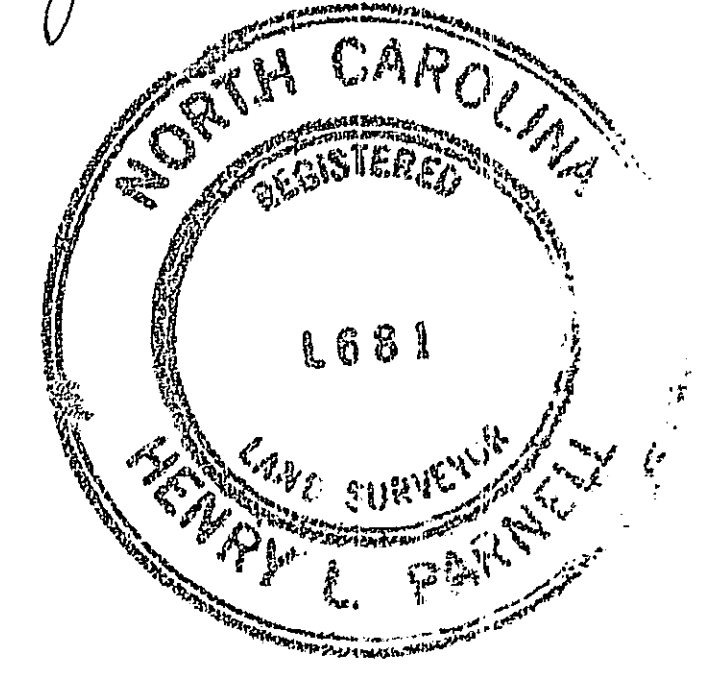

CHAPTER PROPERTIES  
 DEED: 573-328

State of North Carolina  
 County of Mecklenburg  
 I, Sandy M. Huneault a Notary Public in and for the County of Mecklenburg and State of North Carolina, do hereby certify that Henry L. Parnell surveyor personally appeared before me this day and acknowledged the due execution of the foregoing certificate and upon his oath swore to the truth of the statements set forth therein.  
 Witness my hand and notarial seal, this 10th day of December 1987.

Sandy M. Huneault  
 Notary Public

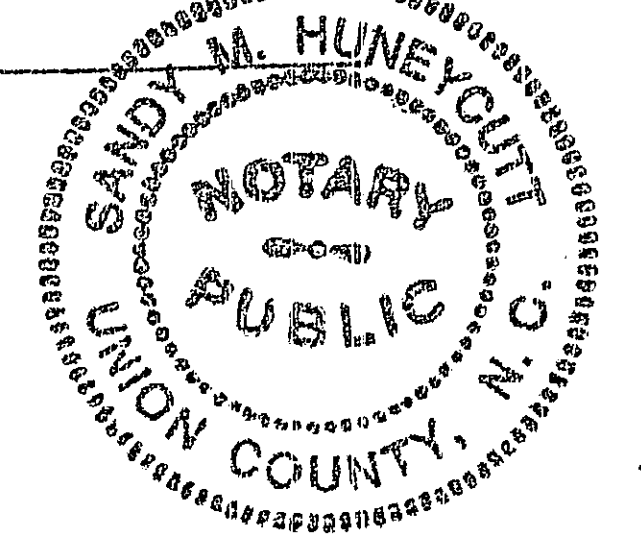

My com. expires: 10/1/89

THIS PLAT IS NOT SUBJECT TO THE PROVISIONS OF THE CITY OF CHARLOTTE OR MECKLENBURG COUNTY SUBDIVISION ORDINANCES AND DOES NOT REQUIRE THE APPROVAL OF THE CHARLOTTE-MECKLENBURG PLANNING COMMISSION.

CHARLOTTE-MECKLENBURG PLANNING COMMISSION

R. H. Hunsberger 12/10/87  
 DATE

State of North Carolina, County of Mecklenburg  
 The foregoing certificate of Henry L. Parnell a Registered Surveyor and Sandy M. Huneault a Notary Public in and for the County of Mecklenburg and State of North Carolina, are certified to be correct. This 12th day of December, 1987.  
 Charles E. Crowder, Register of Deeds, By Henry L. Parnell Deputy

1302.80 TO PRESSLEY ROAD E.I.P.

**DWIGHT EVANS ROAD**  
 60' R/W

State of North Carolina }  
 County of Mecklenburg } **Certification**  
 Charles H. Wheatley, being first duly sworn, deposes and says that he is a licensed architect registered under North Carolina law (Certificate no. 596); that he has directly supervised the preparation of the attached plans of the "D'Evans Condominium Project," and that he certifies that to the best of his knowledge and belief, the attached plans contain all of the information required by

Para. 41C-2.109 of the North Carolina General Statutes (North Carolina Condominium Act) and such plans fully and accurately depict the layout, location, floor and eave elevations, unit numbers and dimensions of the units as built.  
 This the 15th day of December 1987


Charles H. Wheatley  
 Charles H. Wheatley, Architect  
 N.C. Registration Number 596




Sworn to and subscribed to before me this the 15th day of December 1987  
Linda M. Nestlank (Mallison)  
 Notary Public  
 My Commission expires: 03-24-91

PRESENTED FOR REGISTRATION  
APR 21 2 30 PM '88  
CHARLES E. CROWDER  
REGISTER OF DEEDS  
MECKLENBURG CO. N.C.


State of North Carolina, County of Mecklenburg  
The foregoing certificate(s) of  
Linda M. Westbrook (Mattison)  
a Notary Public (are) certified  
to be correct.  
This 19 day of April 19 88  
Charles E. Crowder, Register of Deeds  
By Charles E. Crowder Deputy

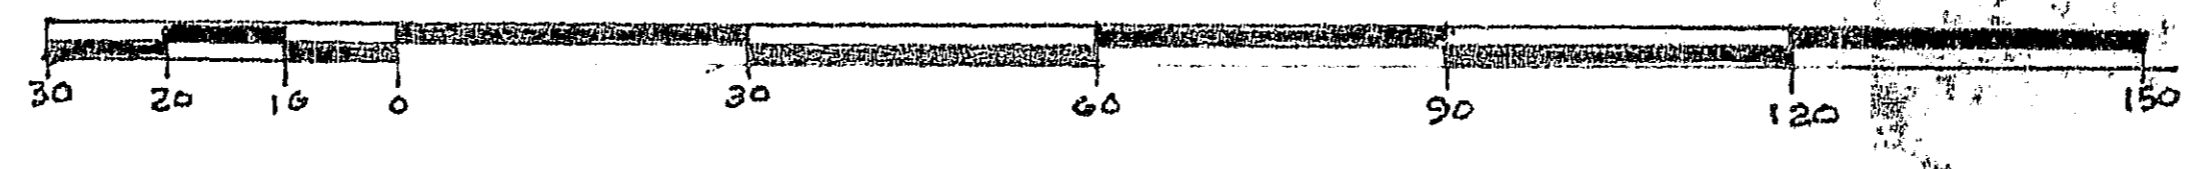

REVISION OF PLAT RECORDED IN OWNERSHIP UNIT FILE 351 PAGE 1

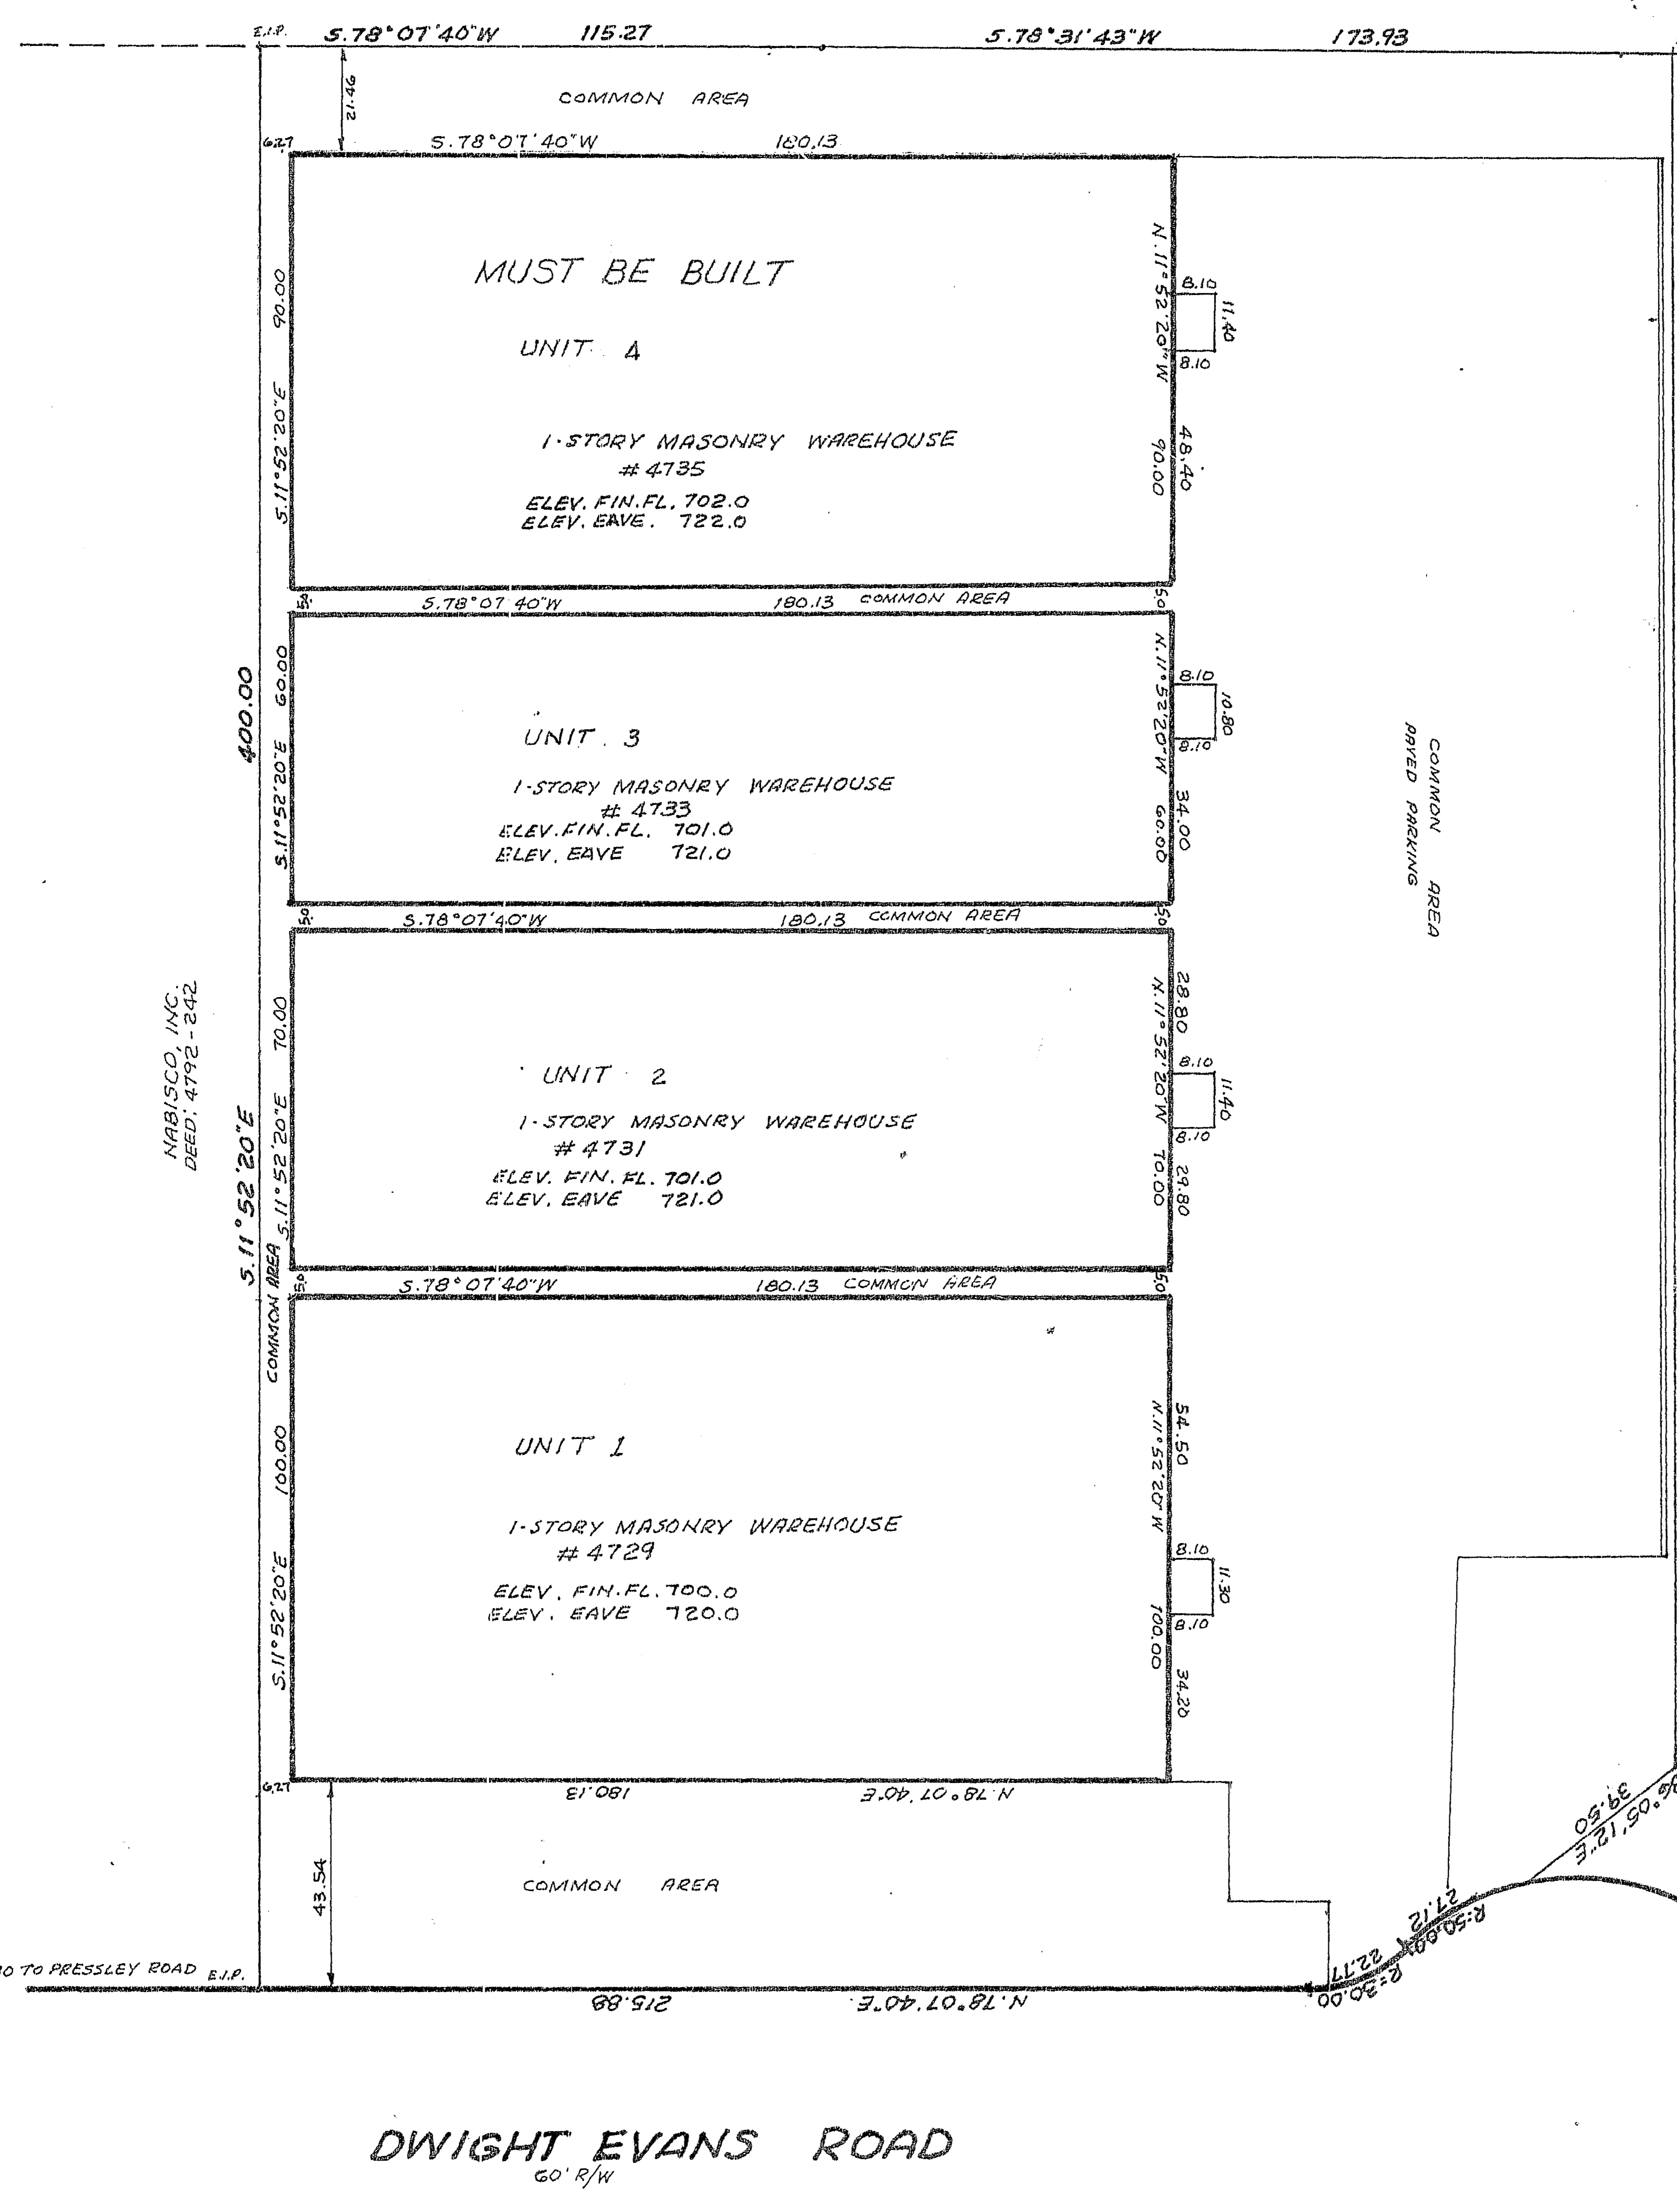

State of North Carolina  
County of Mecklenburg  
The undersigned surveyor, being duly sworn, deposes and says that the plat upon which this certificate appears was prepared in accordance with G.S. 47-30 as amended, to the best of his knowledge and belief and was prepared from a correct survey made by him on the 18th day of April, 1988.  
Maximum error of closure of 1:10,000  
Paid error-of angular closure of 7.5" PER ANGLE

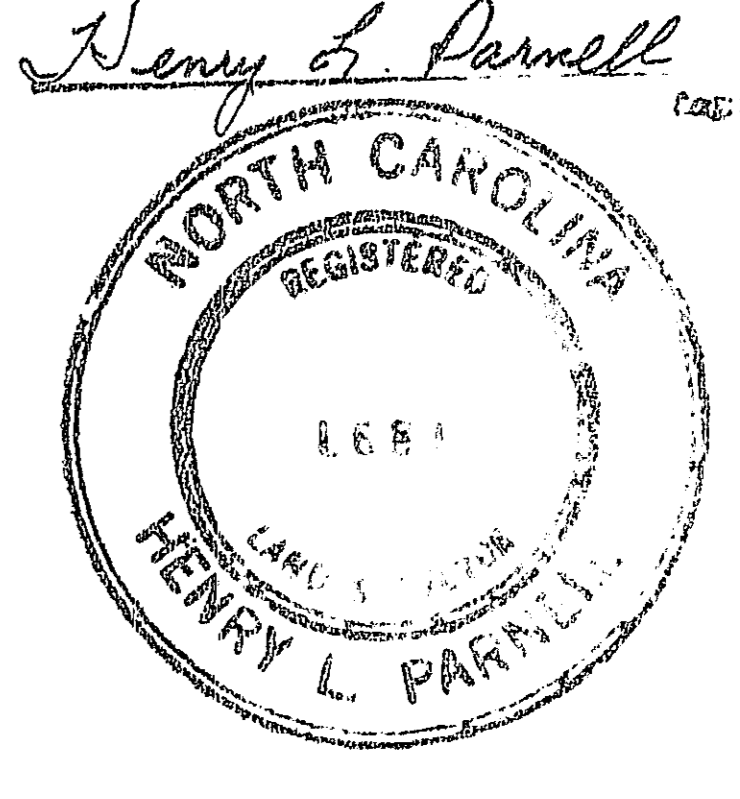


State of North Carolina  
County of Mecklenburg  
I, Linda M. Westbrook (Mattison)  
County of Mecklenburg and State of North Carolina, do hereby certify that Henry L. Parnell appears before me this day of April, 1988, and upon his oath sets forth the foregoing facts.  
Witness my hand and notarial seal this 18th day of April, 1988.  
Linda M. Westbrook (Mattison)  
Notary Public  
My commission expires 03-24-91

THIS PLAT IS NOT SUBJECT TO THE PROVISIONS OF THE CITY OF CHARLOTTE OR MECKLENBURG COUNTY SUBDIVISION ORDINANCES AND DOES NOT REQUIRE THE APPROVAL OF THE CHARLOTTE-MECKLENBURG PLANNING COMMISSION.

CHARLOTTE-MECKLENBURG PLANNING COMMISSION  
Charles H. Wheatley 4/20/88  
ACTING SECRETARY DATE

STATE OF NORTH CAROLINA  
COUNTY OF MECKLENBURG  
CERTIFICATION  
Charles H. Wheatley, being first duly sworn, deposes and says that he is a licensed architect registered under North Carolina law (Certificate No. 596); that he has directly supervised the preparation of the attached plans of the "D' Evans Condominium Project, and that he certifies that to the best of his knowledge and belief, the attached plans contain all of the information required by Para. 47C-2-109 of the North Carolina General Statutes (North Carolina Condominium Act) and such plans fully and accurately depict the layout, location, floor and eave elevations, unit numbers and dimensions of the units as built.  
This the 19th day of April, 1988.

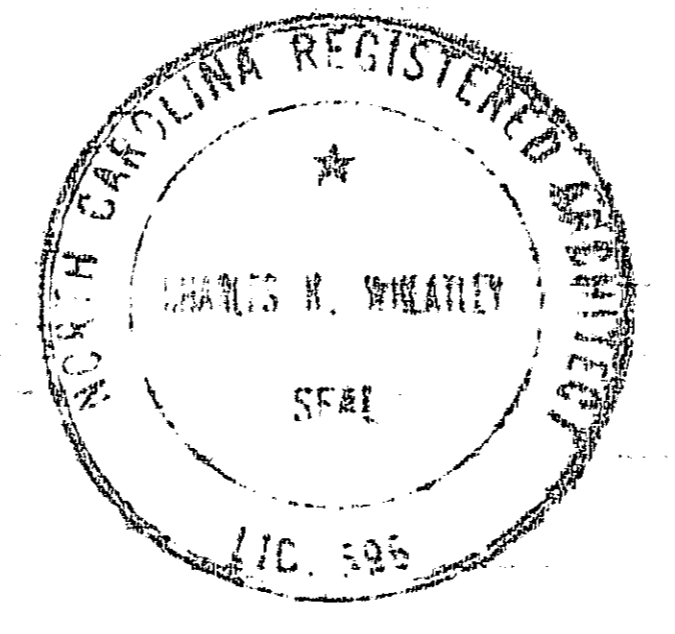

sworn to and subscribed to before me this the 19th day of April 1988.  
Linda M. Westbrook (Mattison)  
Notary Public  
My Commission expires: 03-24-91

